



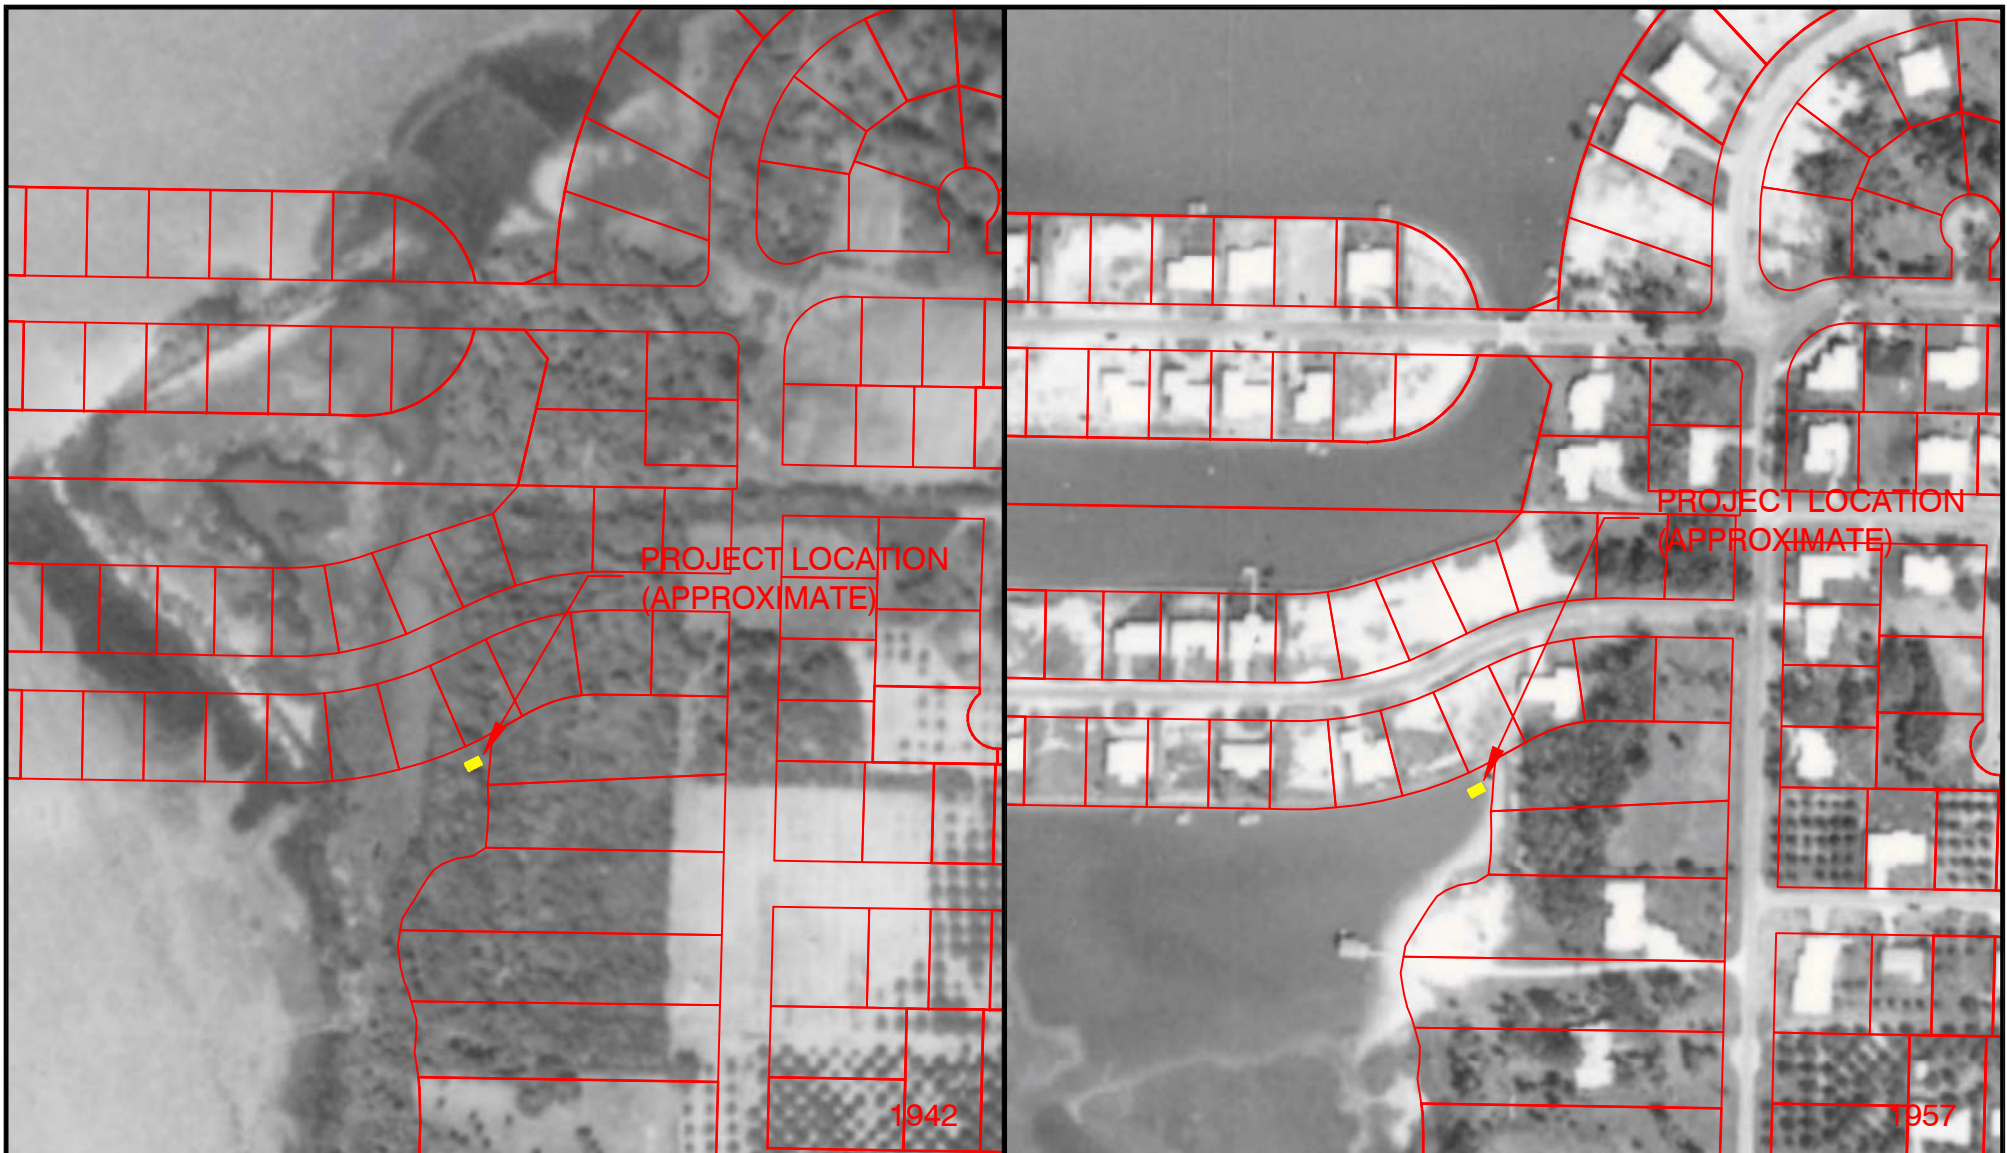

WATERFRONT PROPERTY SERVICES, LLC.
dba GATOR DREDGING
13630 50TH WAY NORTH
CLEARWATER, FL 33760
PHONE 727. 527.1300 FAX 727. 527. 1303
www.gatordredging.com

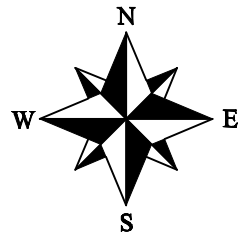

MLW = -1.25 ft-NAVD
MHW = +0.64 ft-NAVD

FOR
Seth Sekeres

PROPOSAL ☐
PRELIMINARY ☐
PERMITTING ☒
ISSUED FOR CONSTRUCTION ☐
RECORD DRAWING ☐

PERMIT_SEKERES.DWG

EXHIBIT TITLE
HISTORIC AERIAL - 1942 & 1957


Project Address:

720 Bluff View Drive
Belleair Bluff, FL 33770


DATE :
04/20/2017
DRAWN BY:
KCD
CHECKED BY:
TBM
JOB NO.:
XXXXXX

Exhibit No.
EXHIBIT 7B

SCALE: 1" = 250'

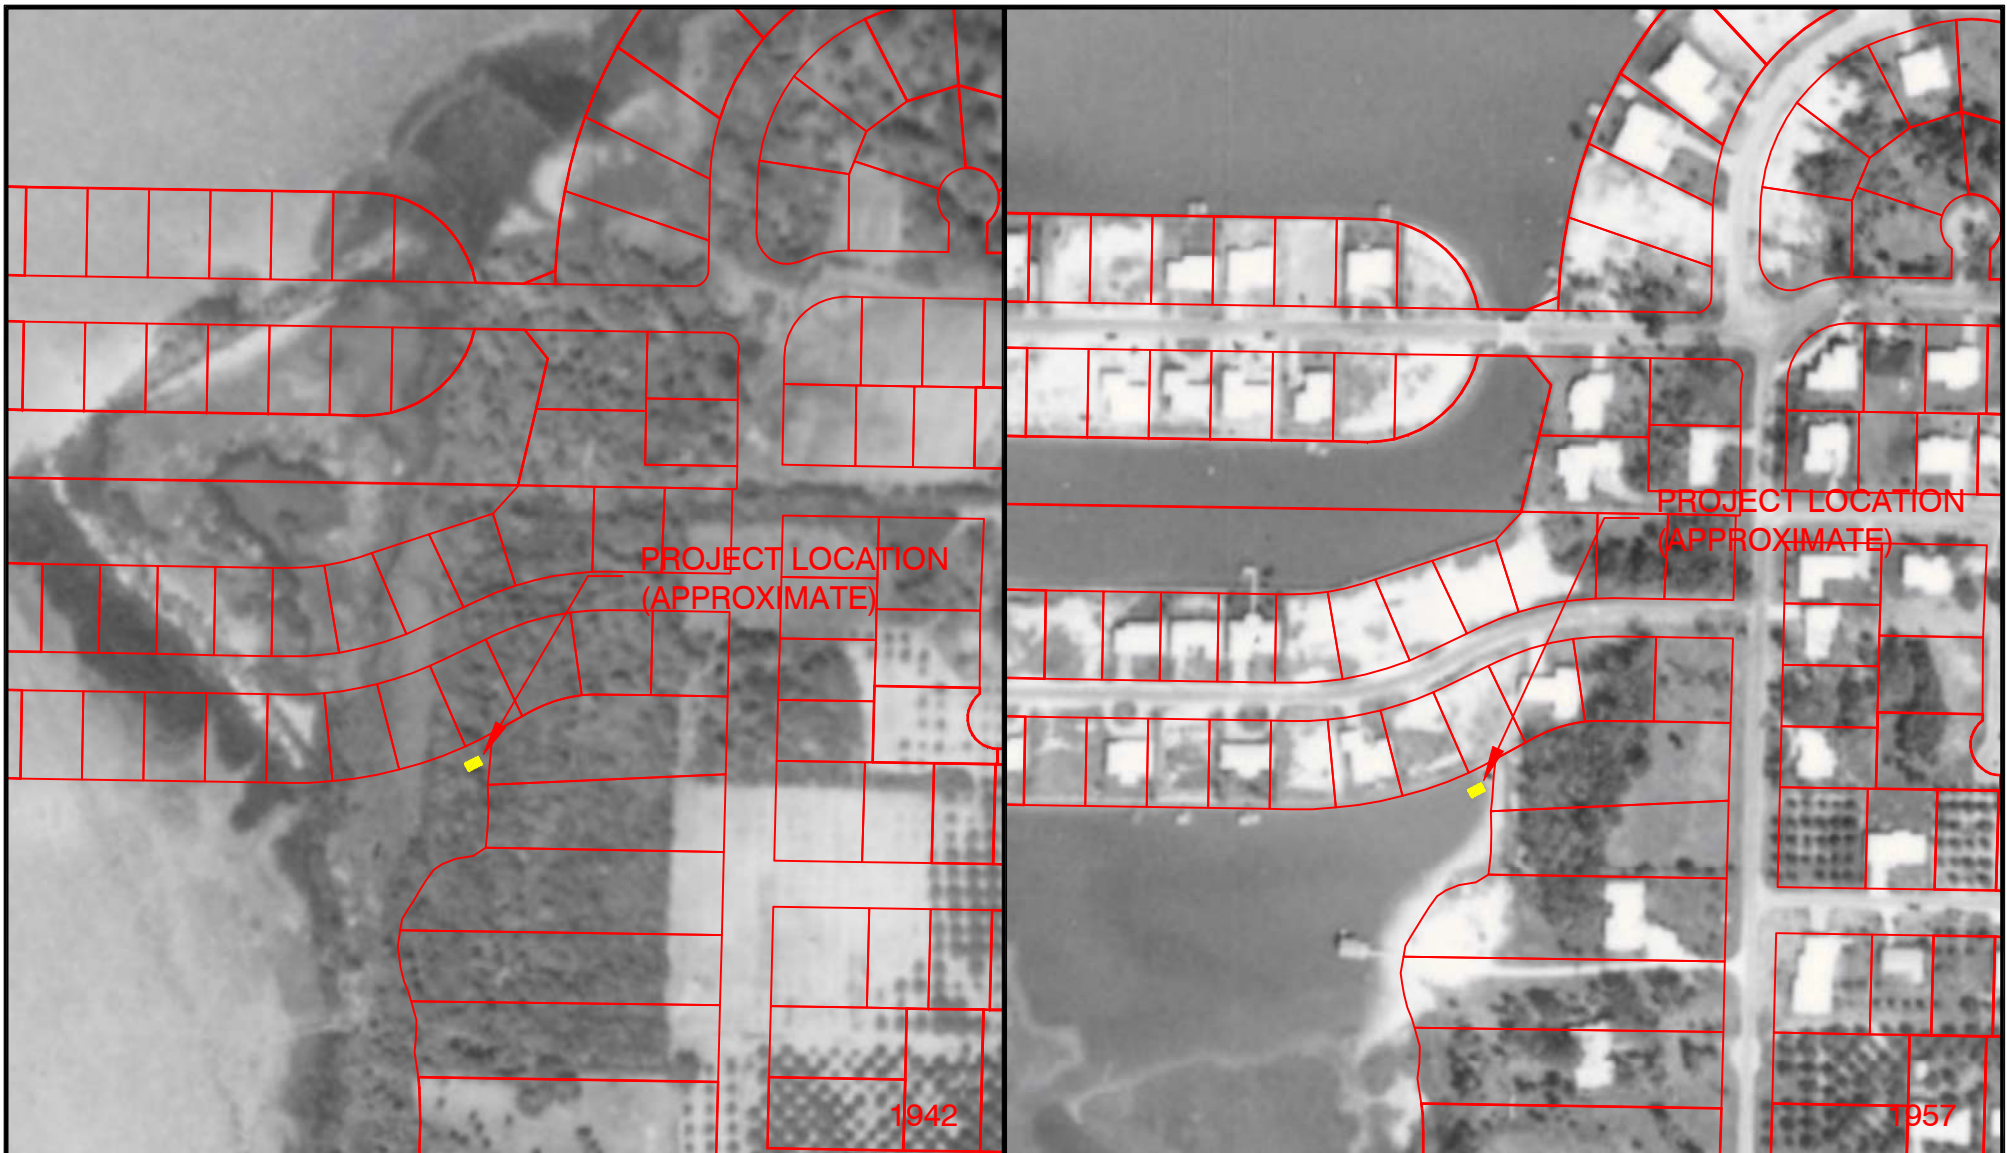

WATERFRONT PROPERTY SERVICES, LLC.
dba GATOR DREDGING
13630 50TH WAY NORTH
CLEARWATER, FL 33760
PHONE 727. 527.1300 FAX 727. 527. 1303
www.gatordredging.com

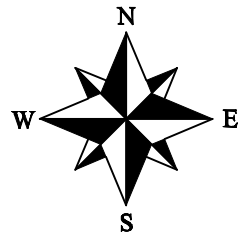

MLW = -1.25 ft-NAVD
MHW = +0.64 ft-NAVD

FOR
Seth Sekeres

PROPOSAL ☐
PRELIMINARY ☐
PERMITTING ☒
ISSUED FOR CONSTRUCTION ☐
RECORD DRAWING ☐

PERMIT_SEKERES.DWG

EXHIBIT TITLE
HISTORIC AERIAL - 1942 & 1957


Project Address:

720 Bluff View Drive
Belleair Bluff, FL 33770


DATE :
04/20/2017
DRAWN BY:
KCD
CHECKED BY:
TBM
JOB NO.:
XXXXXX

Exhibit No.
EXHIBIT 7B

SCALE: 1" = 250'

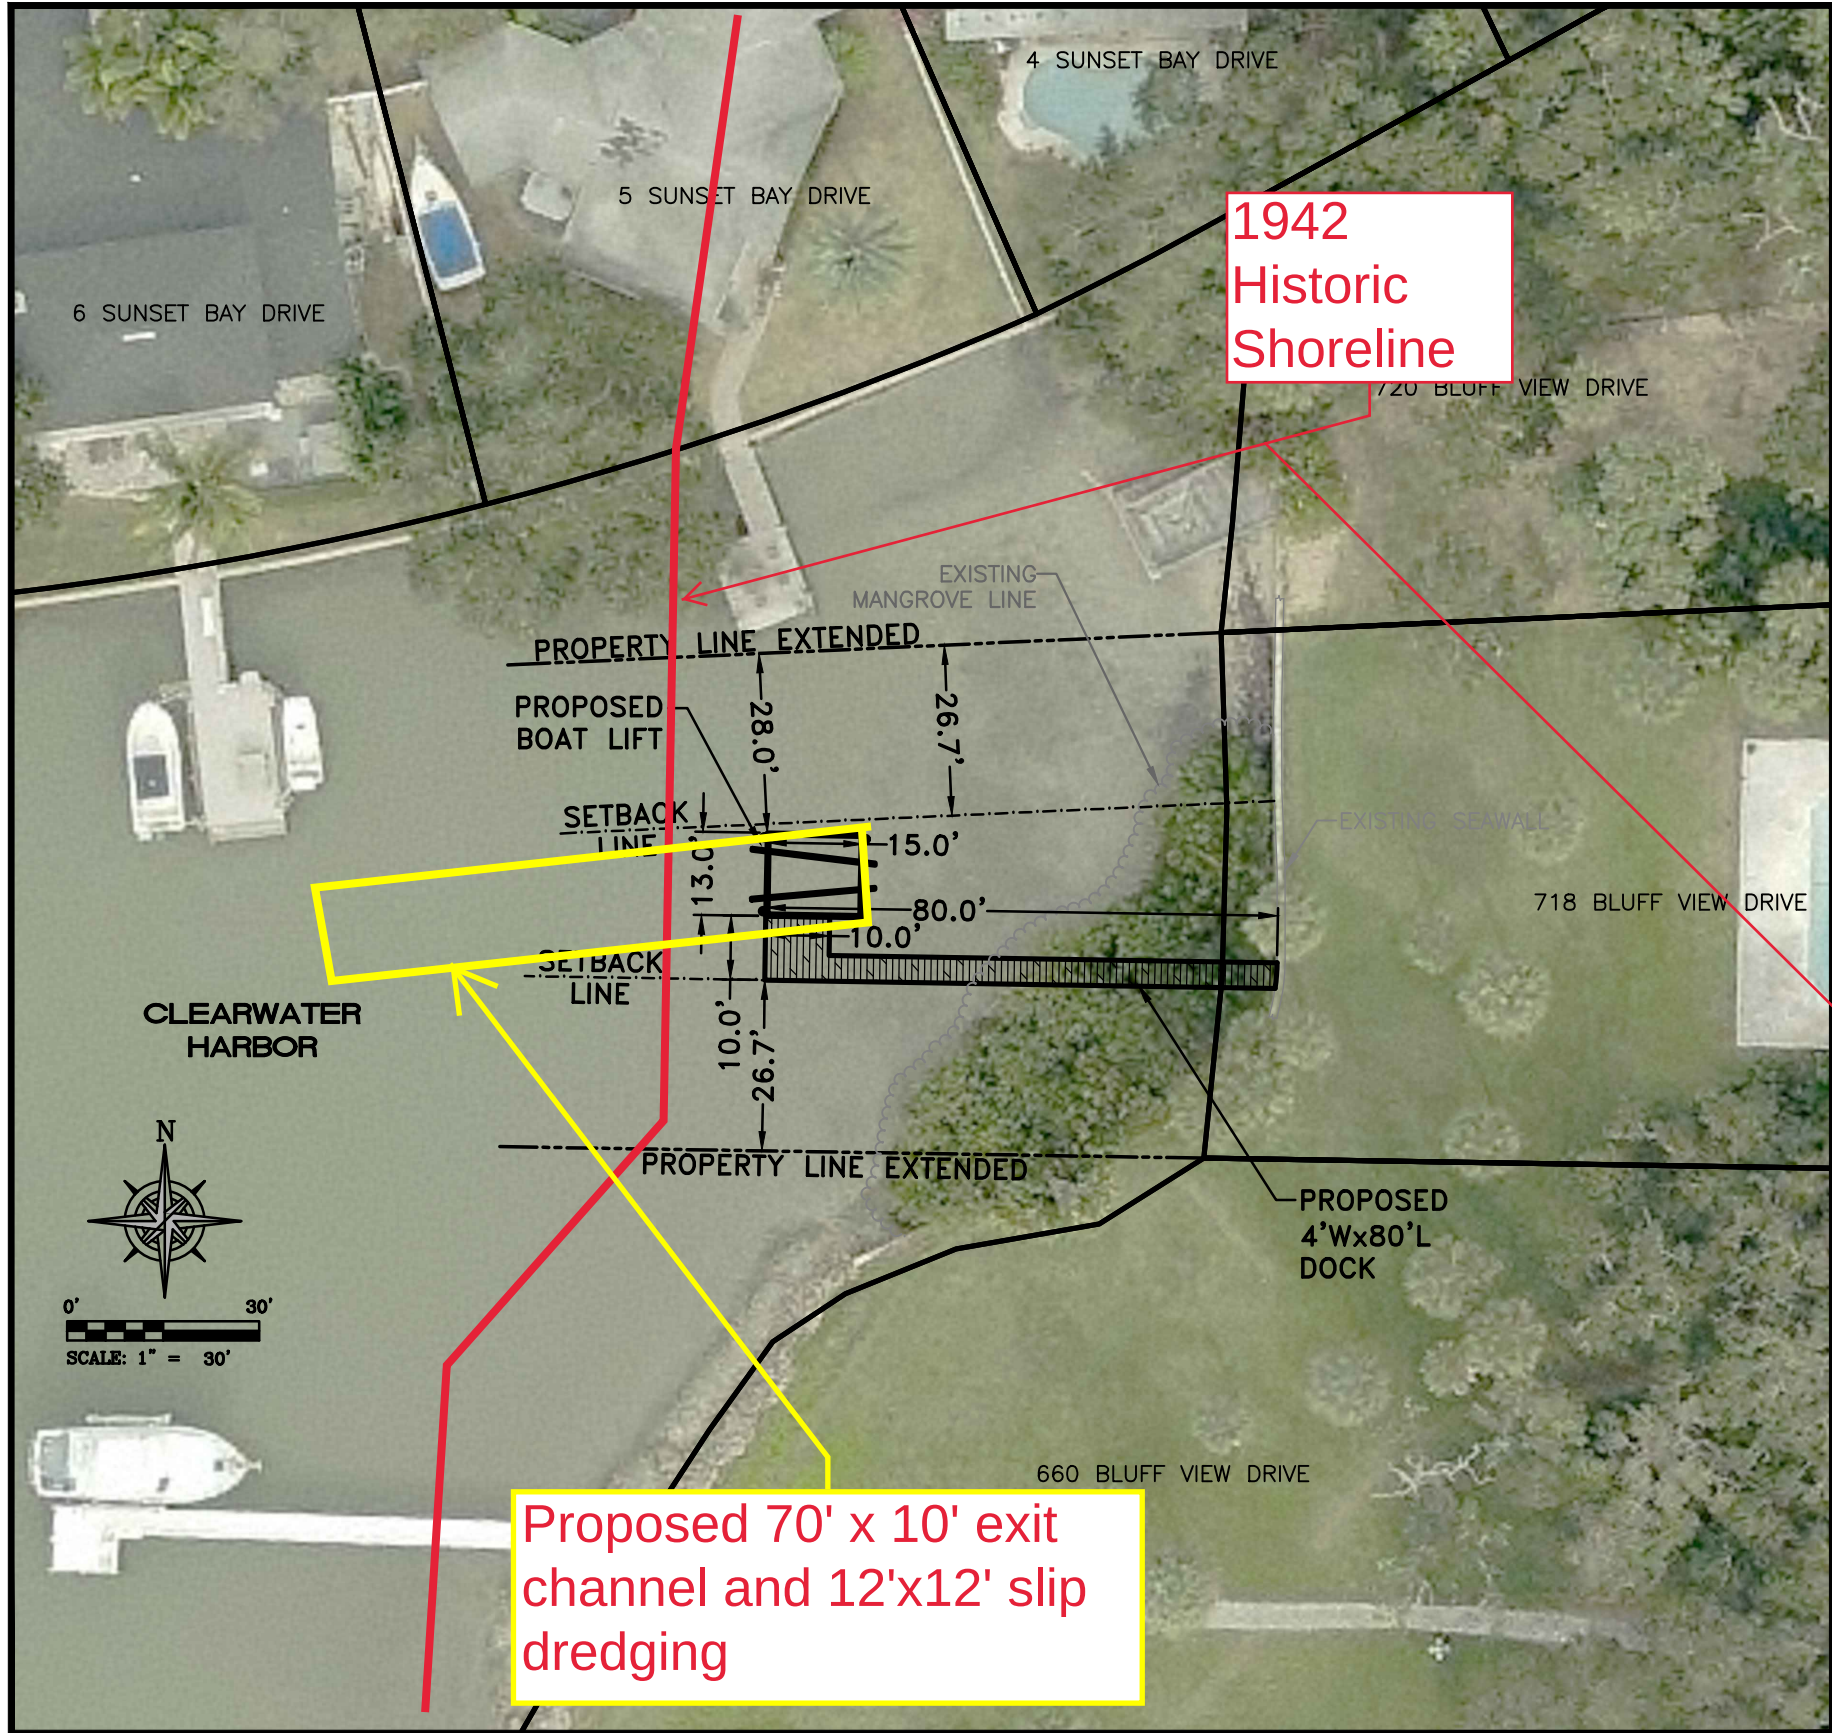

VICINITY MAP

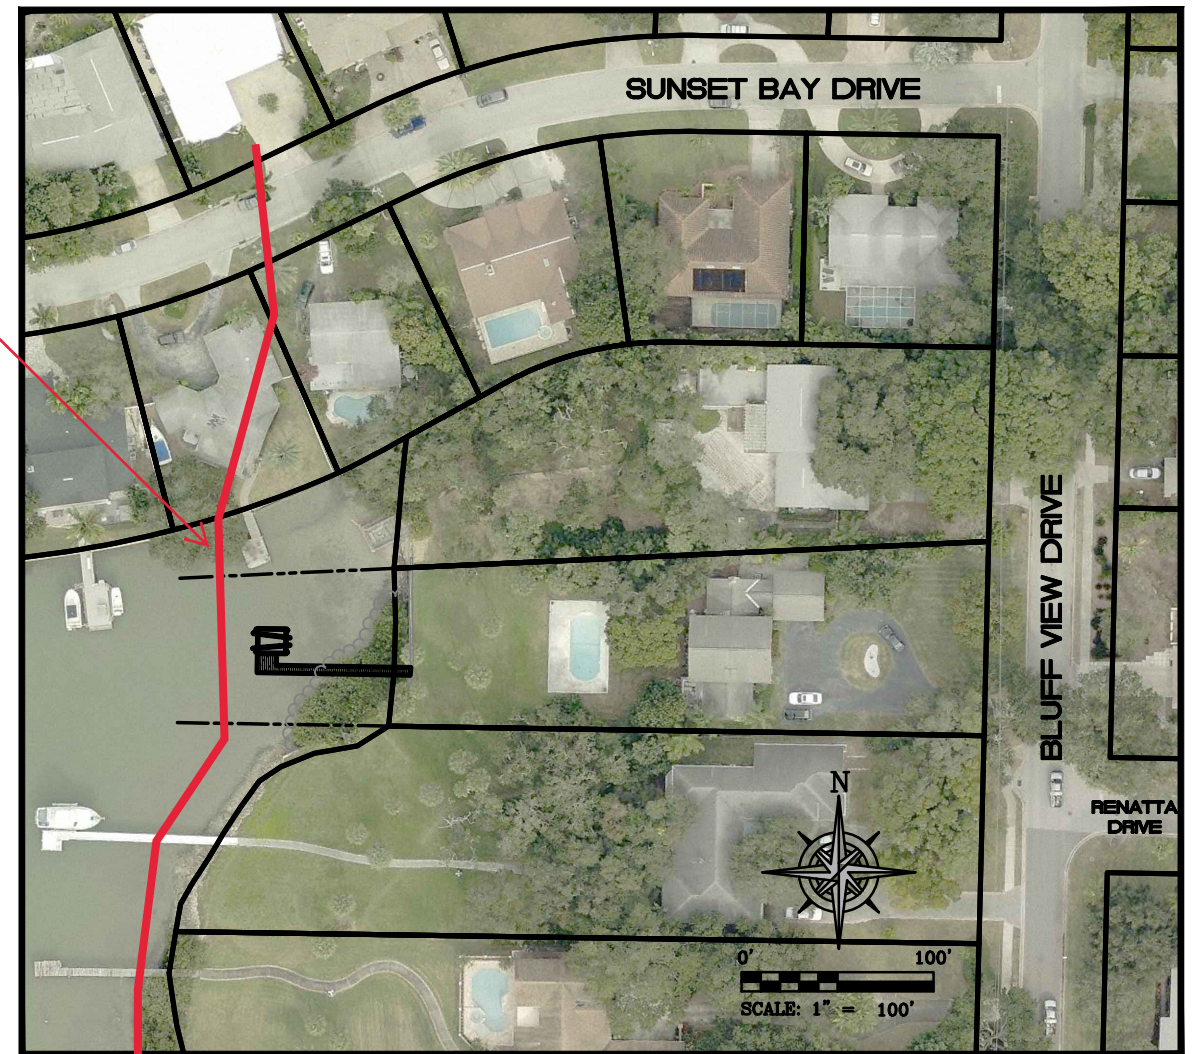


DESIGN:	APC	I, ALBERT CARRIER, HEREBY CERTIFY AS A LICENSED PROFESSIONAL ENGINEER, REGISTERED IN ACCORDANCE WITH FLORIDA STATUTE 471 (481) THAT THE ABOVE PROJECT'S SITE AND/OR CONSTRUCTION PLANS, TO THE BEST OF MY KNOWLEDGE, INFORMATION AND BELIEF, WILL MEET APPLICABLE DESIGN CRITERIA SPECIFIED BY CITY MUNICIPAL ORDINANCE, STATE AND FEDERAL ESTABLISHED STANDARDS. I UNDERSTAND THAT IT IS MY RESPONSIBILITY AS THE PROJECT'S PROFESSIONAL ENGINEER TO PERFORM A QUALITY ASSURANCE REVIEW OF THESE SUBMITTED PLANS.
DRAWN:	DES	
CHECK:	CAC	

DEUEL & ASSOCIATES
CONSULTING ENGINEERS LAND SURVEYORS LAND PLANNERS
565 SOUTH HERCULES AVENUE, CLEARWATER, FL 33764
PHONE 727.822.4151
WWW.DEUELENGINEERING.COM
CERTIFICATE OF AUTHORIZATION # 26320 LICENSED BUSINESS # 107


DOCK IMPROVEMENT PLAN
718 BLUFF VIEW DRIVE
CONCEPT PLAN 1
BELLEAIR BLUFFS FLORIDA

ALBERT P. CARRIER, P.E. 53990

WORK ORDER	2017-76E
DATE:	3/2/2018
SCALE:	1" = 30'
SHEET NO.	1 OF 1

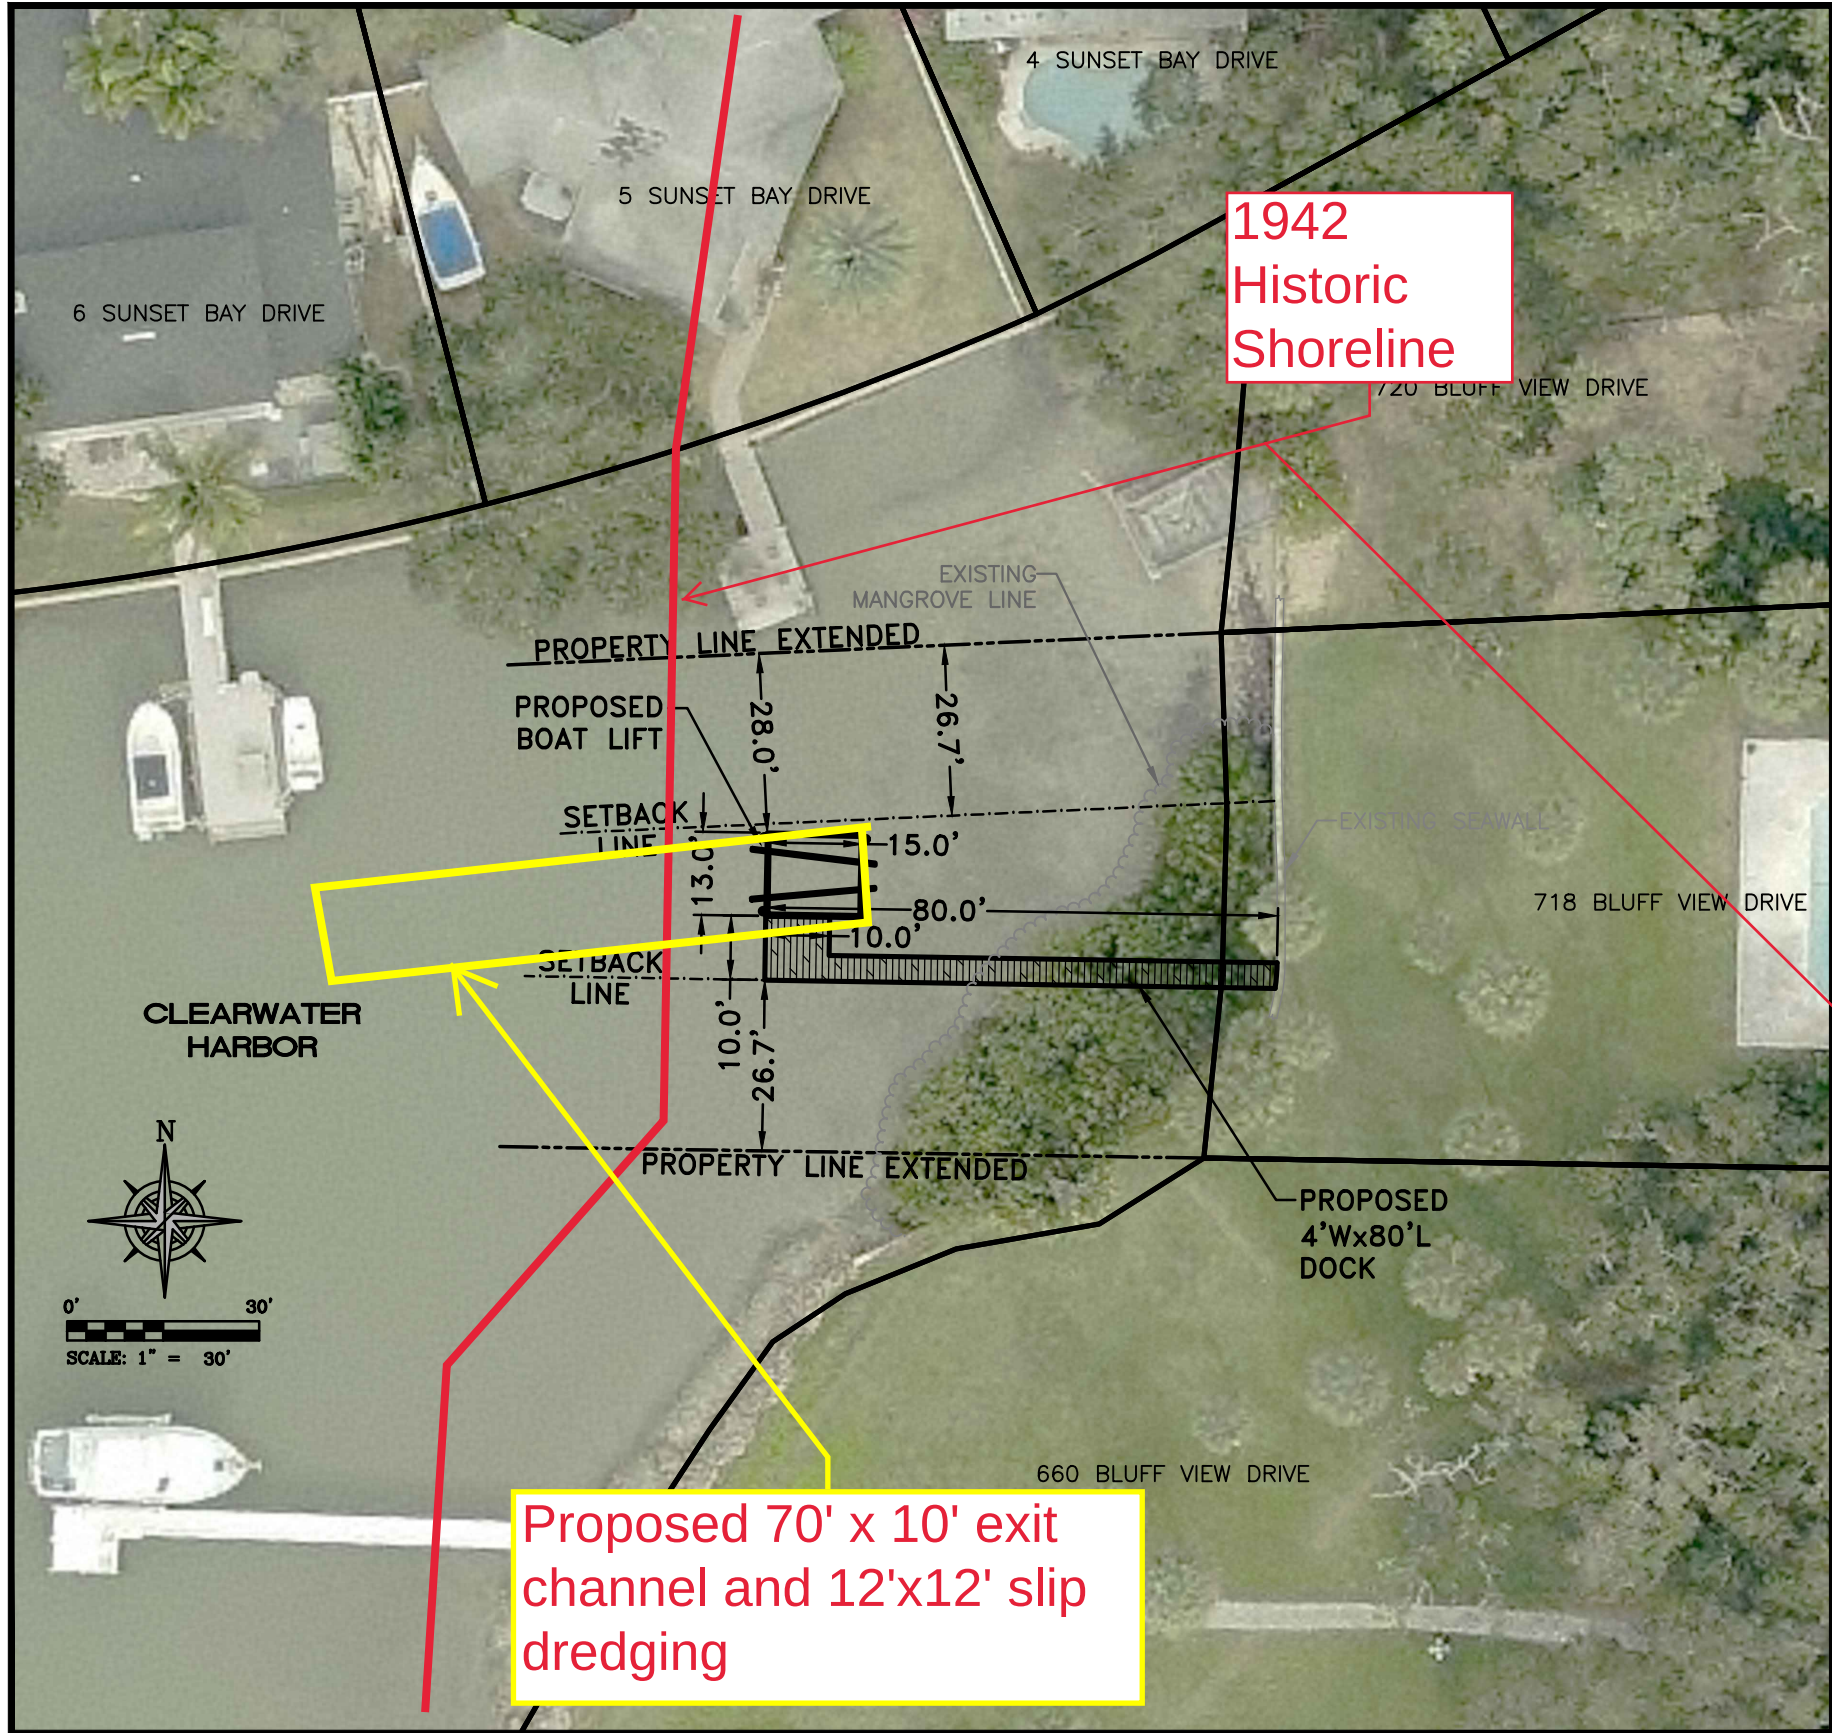

VICINITY MAP

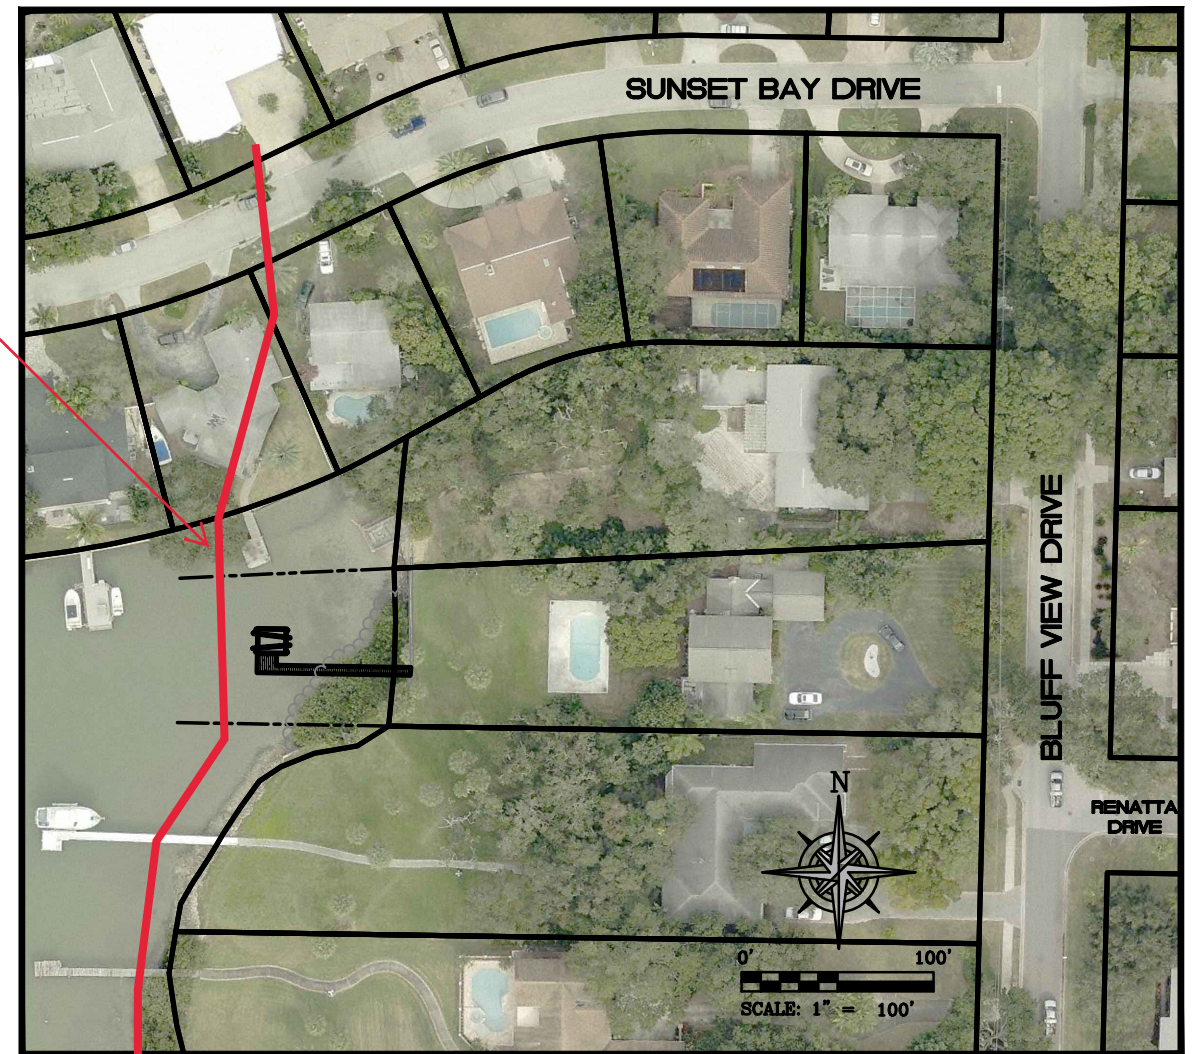


DESIGN:	APC	I, ALBERT CARRIER, HEREBY CERTIFY AS A LICENSED PROFESSIONAL ENGINEER, REGISTERED IN ACCORDANCE WITH FLORIDA STATUTE 471 (481) THAT THE ABOVE PROJECT'S SITE AND/OR CONSTRUCTION PLANS, TO THE BEST OF MY KNOWLEDGE, INFORMATION AND BELIEF, WILL MEET APPLICABLE DESIGN CRITERIA SPECIFIED BY CITY MUNICIPAL ORDINANCE, STATE AND FEDERAL ESTABLISHED STANDARDS. I UNDERSTAND THAT IT IS MY RESPONSIBILITY AS THE PROJECT'S PROFESSIONAL ENGINEER TO PERFORM A QUALITY ASSURANCE REVIEW OF THESE SUBMITTED PLANS.
DRAWN:	DES	
CHECK:	CAC	

DEUEL & ASSOCIATES
CONSULTING ENGINEERS LAND SURVEYORS LAND PLANNERS
565 SOUTH HERCULES AVENUE, CLEARWATER, FL 33764
PHONE 727.822.4151
WWW.DEUELENGINEERING.COM
CERTIFICATE OF AUTHORIZATION # 26320 LICENSED BUSINESS # 107


DOCK IMPROVEMENT PLAN
718 BLUFF VIEW DRIVE
CONCEPT PLAN 1
BELLEAIR BLUFFS FLORIDA

ALBERT P. CARRIER, P.E. 53990

WORK ORDER	2017-76E
DATE:	3/2/2018
SCALE:	1" = 30'
SHEET NO.	1 OF 1

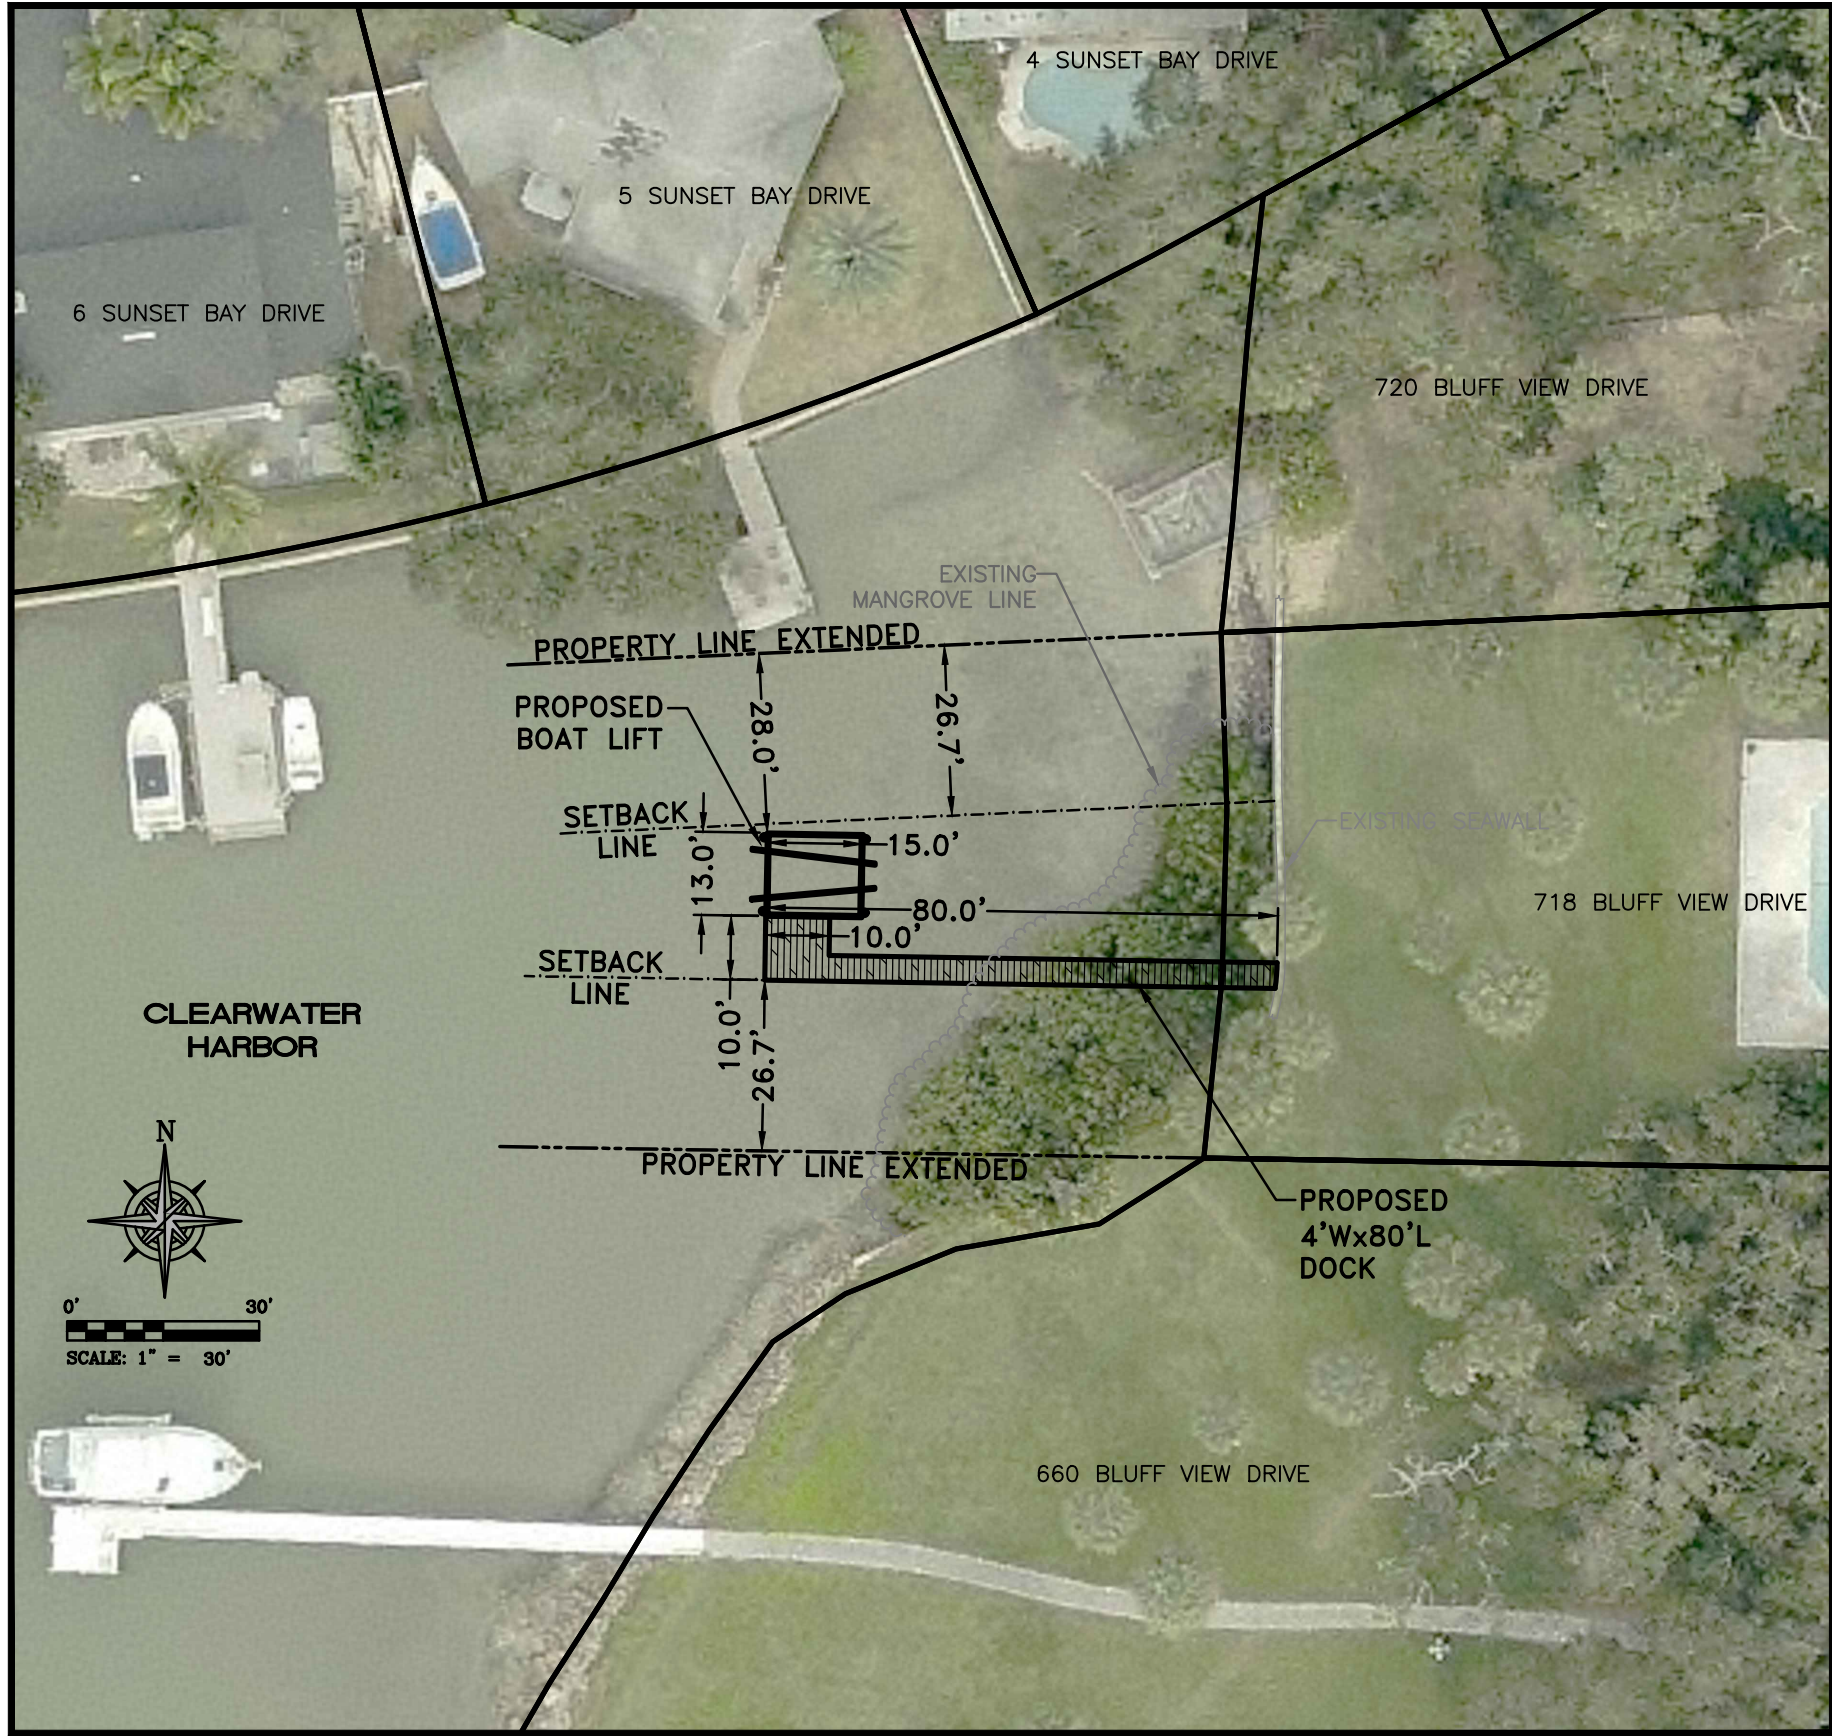

VICINITY MAP

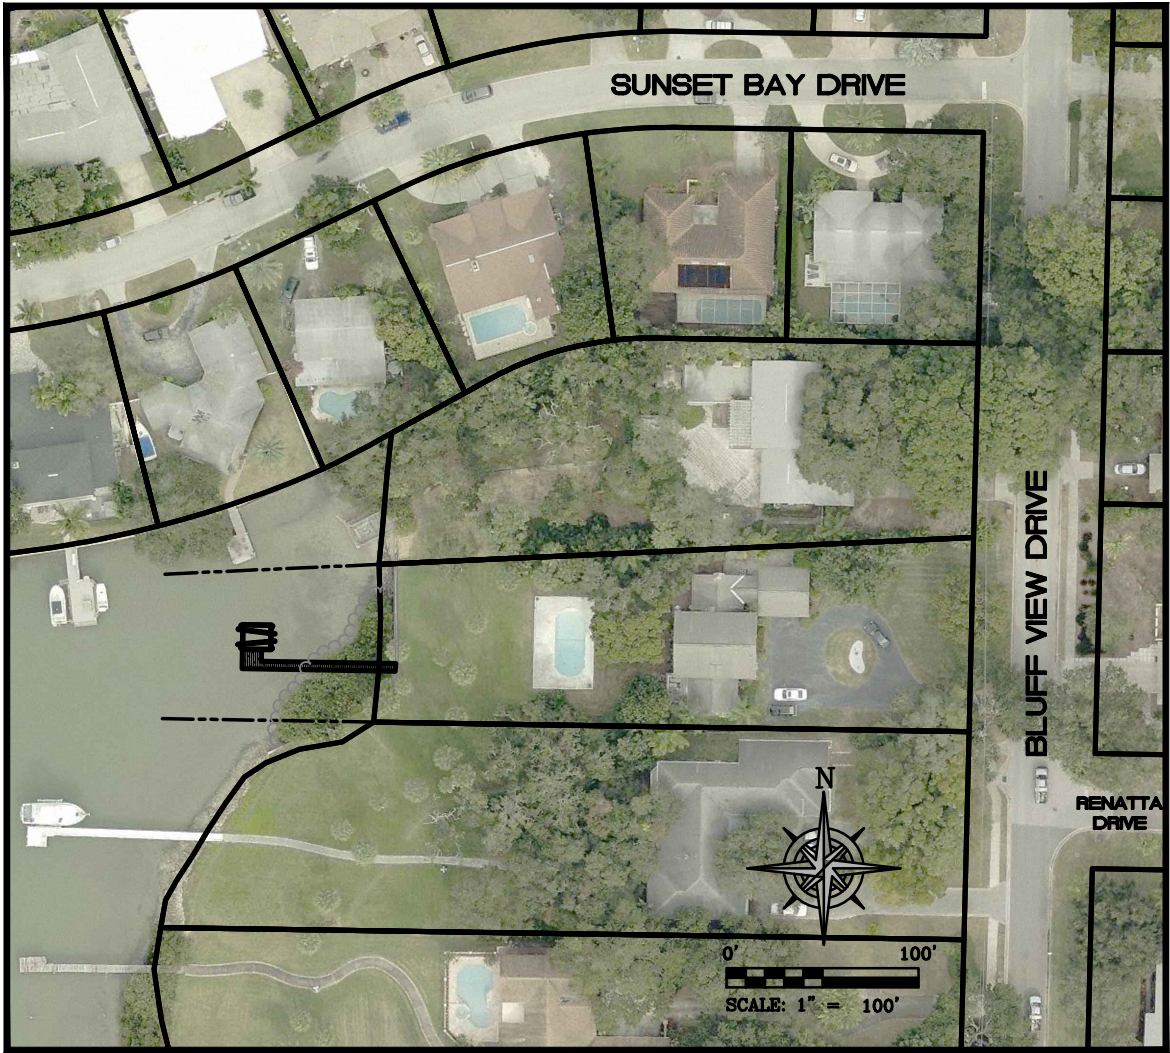


DESIGN:	APC	I, ALBERT CARRIER, HEREBY CERTIFY AS A LICENSED PROFESSIONAL ENGINEER, REGISTERED IN ACCORDANCE WITH FLORIDA STATUTE 471 (481) THAT THE ABOVE PROJECT'S SITE AND/OR CONSTRUCTION PLANS, TO THE BEST OF MY KNOWLEDGE, INFORMATION AND BELIEF, WILL MEET APPLICABLE DESIGN CRITERIA SPECIFIED BY CITY MUNICIPAL ORDINANCE, STATE AND FEDERAL ESTABLISHED STANDARDS. I UNDERSTAND THAT IT IS MY RESPONSIBILITY AS THE PROJECT'S PROFESSIONAL ENGINEER TO PERFORM A QUALITY ASSURANCE REVIEW OF THESE SUBMITTED PLANS.
DRAWN:	DES	
CHECK:	CAC	

DEUEL & ASSOCIATES
CONSULTING ENGINEERS LAND SURVEYORS LAND PLANNERS
565 SOUTH HERCULES AVENUE, CLEARWATER, FL 33764
PHONE 727.822.4151
WWW.DEUELENGINEERING.COM
CERTIFICATE OF AUTHORIZATION # 26320 LICENSED BUSINESS # 107


DOCK IMPROVEMENT PLAN
718 BLUFF VIEW DRIVE
CONCEPT PLAN 1
BELLEAIR BLUFFS FLORIDA

ALBERT P. CARRIER, P.E. 53990

WORK ORDER	2017-76E
DATE:	3/2/2018
SCALE:	1" = 30'
SHEET NO.	1 OF 1

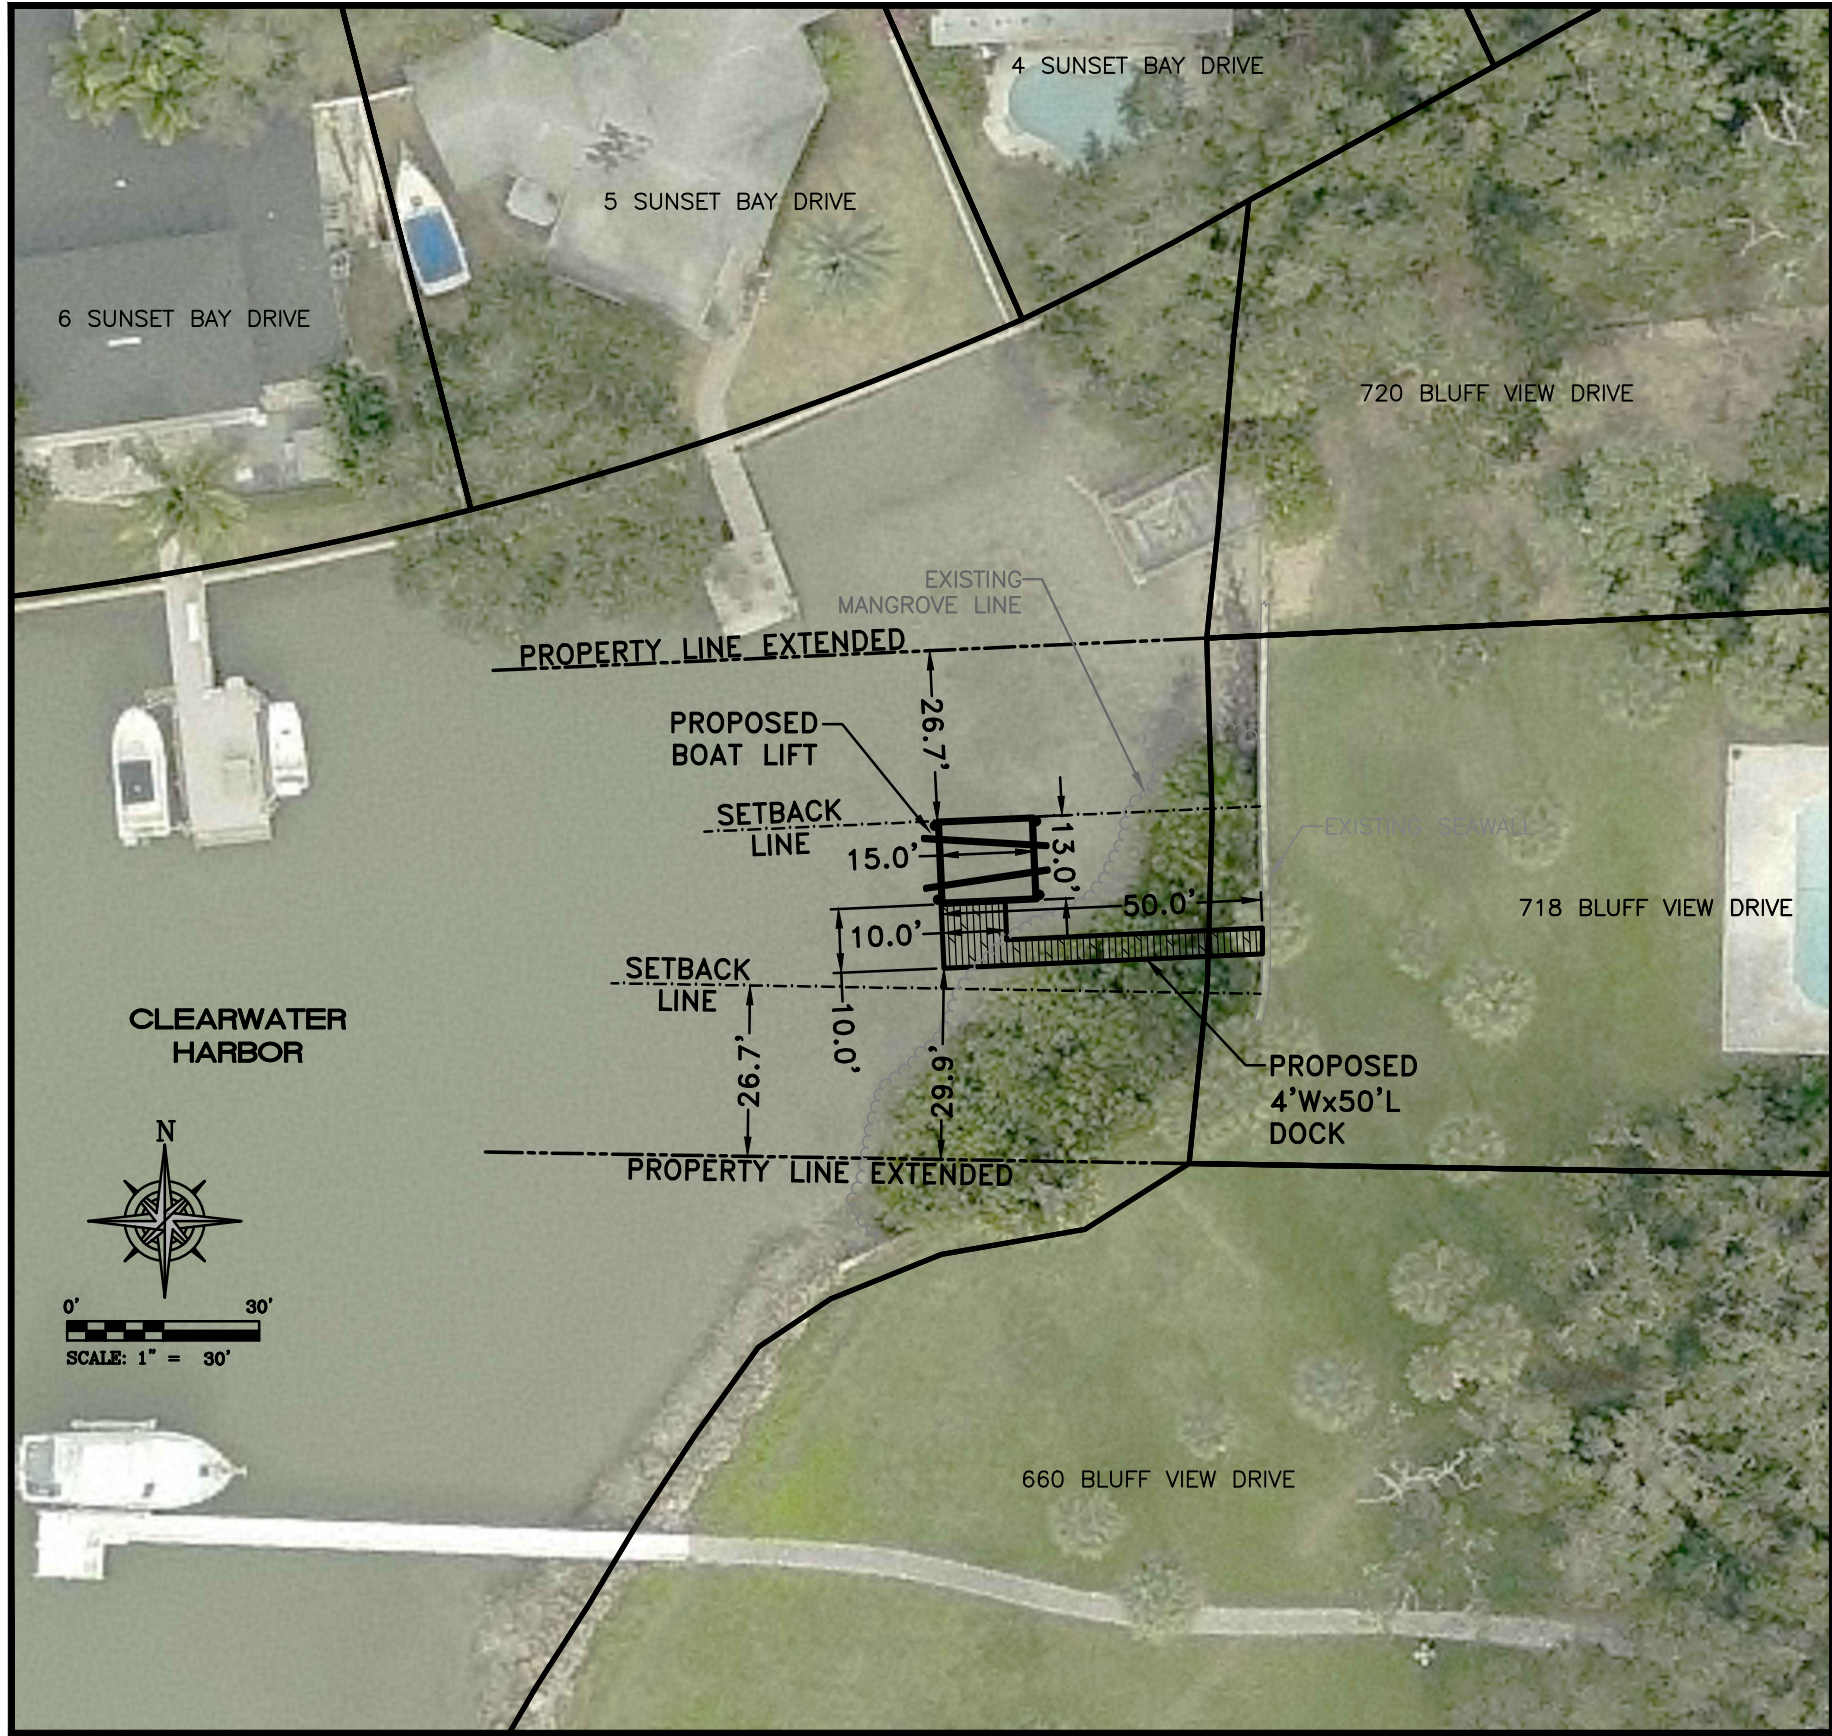

VICINITY MAP

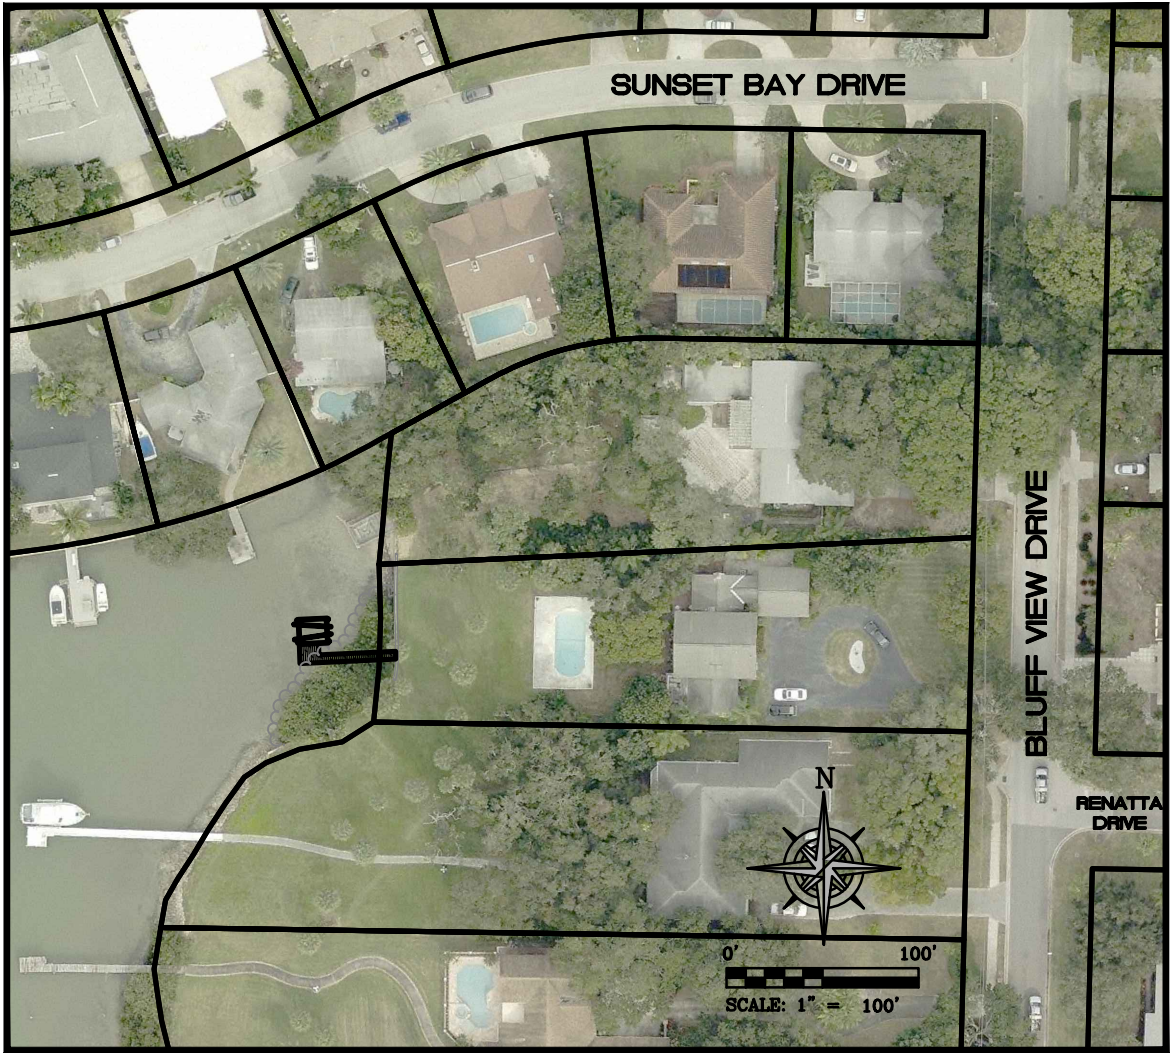

DESIGN:	APC	I, ALBERT CARRIER, HEREBY CERTIFY AS A LICENSED PROFESSIONAL ENGINEER, REGISTERED IN ACCORDANCE WITH FLORIDA STATUTE 471 (481) THAT THE ABOVE PROJECT'S SITE AND/OR CONSTRUCTION PLANS, TO THE BEST OF MY KNOWLEDGE, INFORMATION AND BELIEF, WILL MEET APPLICABLE DESIGN CRITERIA SPECIFIED BY CITY MUNICIPAL ORDINANCE, STATE AND FEDERAL ESTABLISHED STANDARDS. I UNDERSTAND THAT IT IS MY RESPONSIBILITY AS THE PROJECT'S PROFESSIONAL ENGINEER TO PERFORM A QUALITY ASSURANCE REVIEW OF THESE SUBMITTED PLANS.
DRAWN:	DES	
CHECK:	CAC	

DEUEL & ASSOCIATES

CONSULTING ENGINEERS LAND SURVEYORS LAND PLANNERS

565 SOUTH HERCULES AVENUE, CLEARWATER, FL 33764

PHONE 727.822.4151

WWW.DEUELENGINEERING.COM

CERTIFICATE OF AUTHORIZATION # 26320 LICENSED BUSINESS # 107

DOCK IMPROVEMENT PLAN

718 BLUFF VIEW DRIVE

CONCEPT PLAN 2

BELLEAIR BLUFFS

FLORIDA

ALBERT P. CARRIER, P.E. 53990

WORK ORDER	2017-76E
DATE:	3/2/2018
SCALE:	1" = 30'
SHEET NO.	1 OF 1